


Copyright:  
 This drawing is copyright and may not be altered,  
 reproduced or used other than for the Contract Works for  
 which it was issued without the written permission of the  
 Estates & Facilities Directorate.  
 Note:  
 It is assumed that the information on this drawing is  
 correct, however this cannot be guaranteed, and therefore,  
 before any type of works are carried out, a survey would be  
 necessary to validate the information held therein.

Rev A: Waste compound moved  
 Rev B: Additional road markings added  
 Rev C: etc...

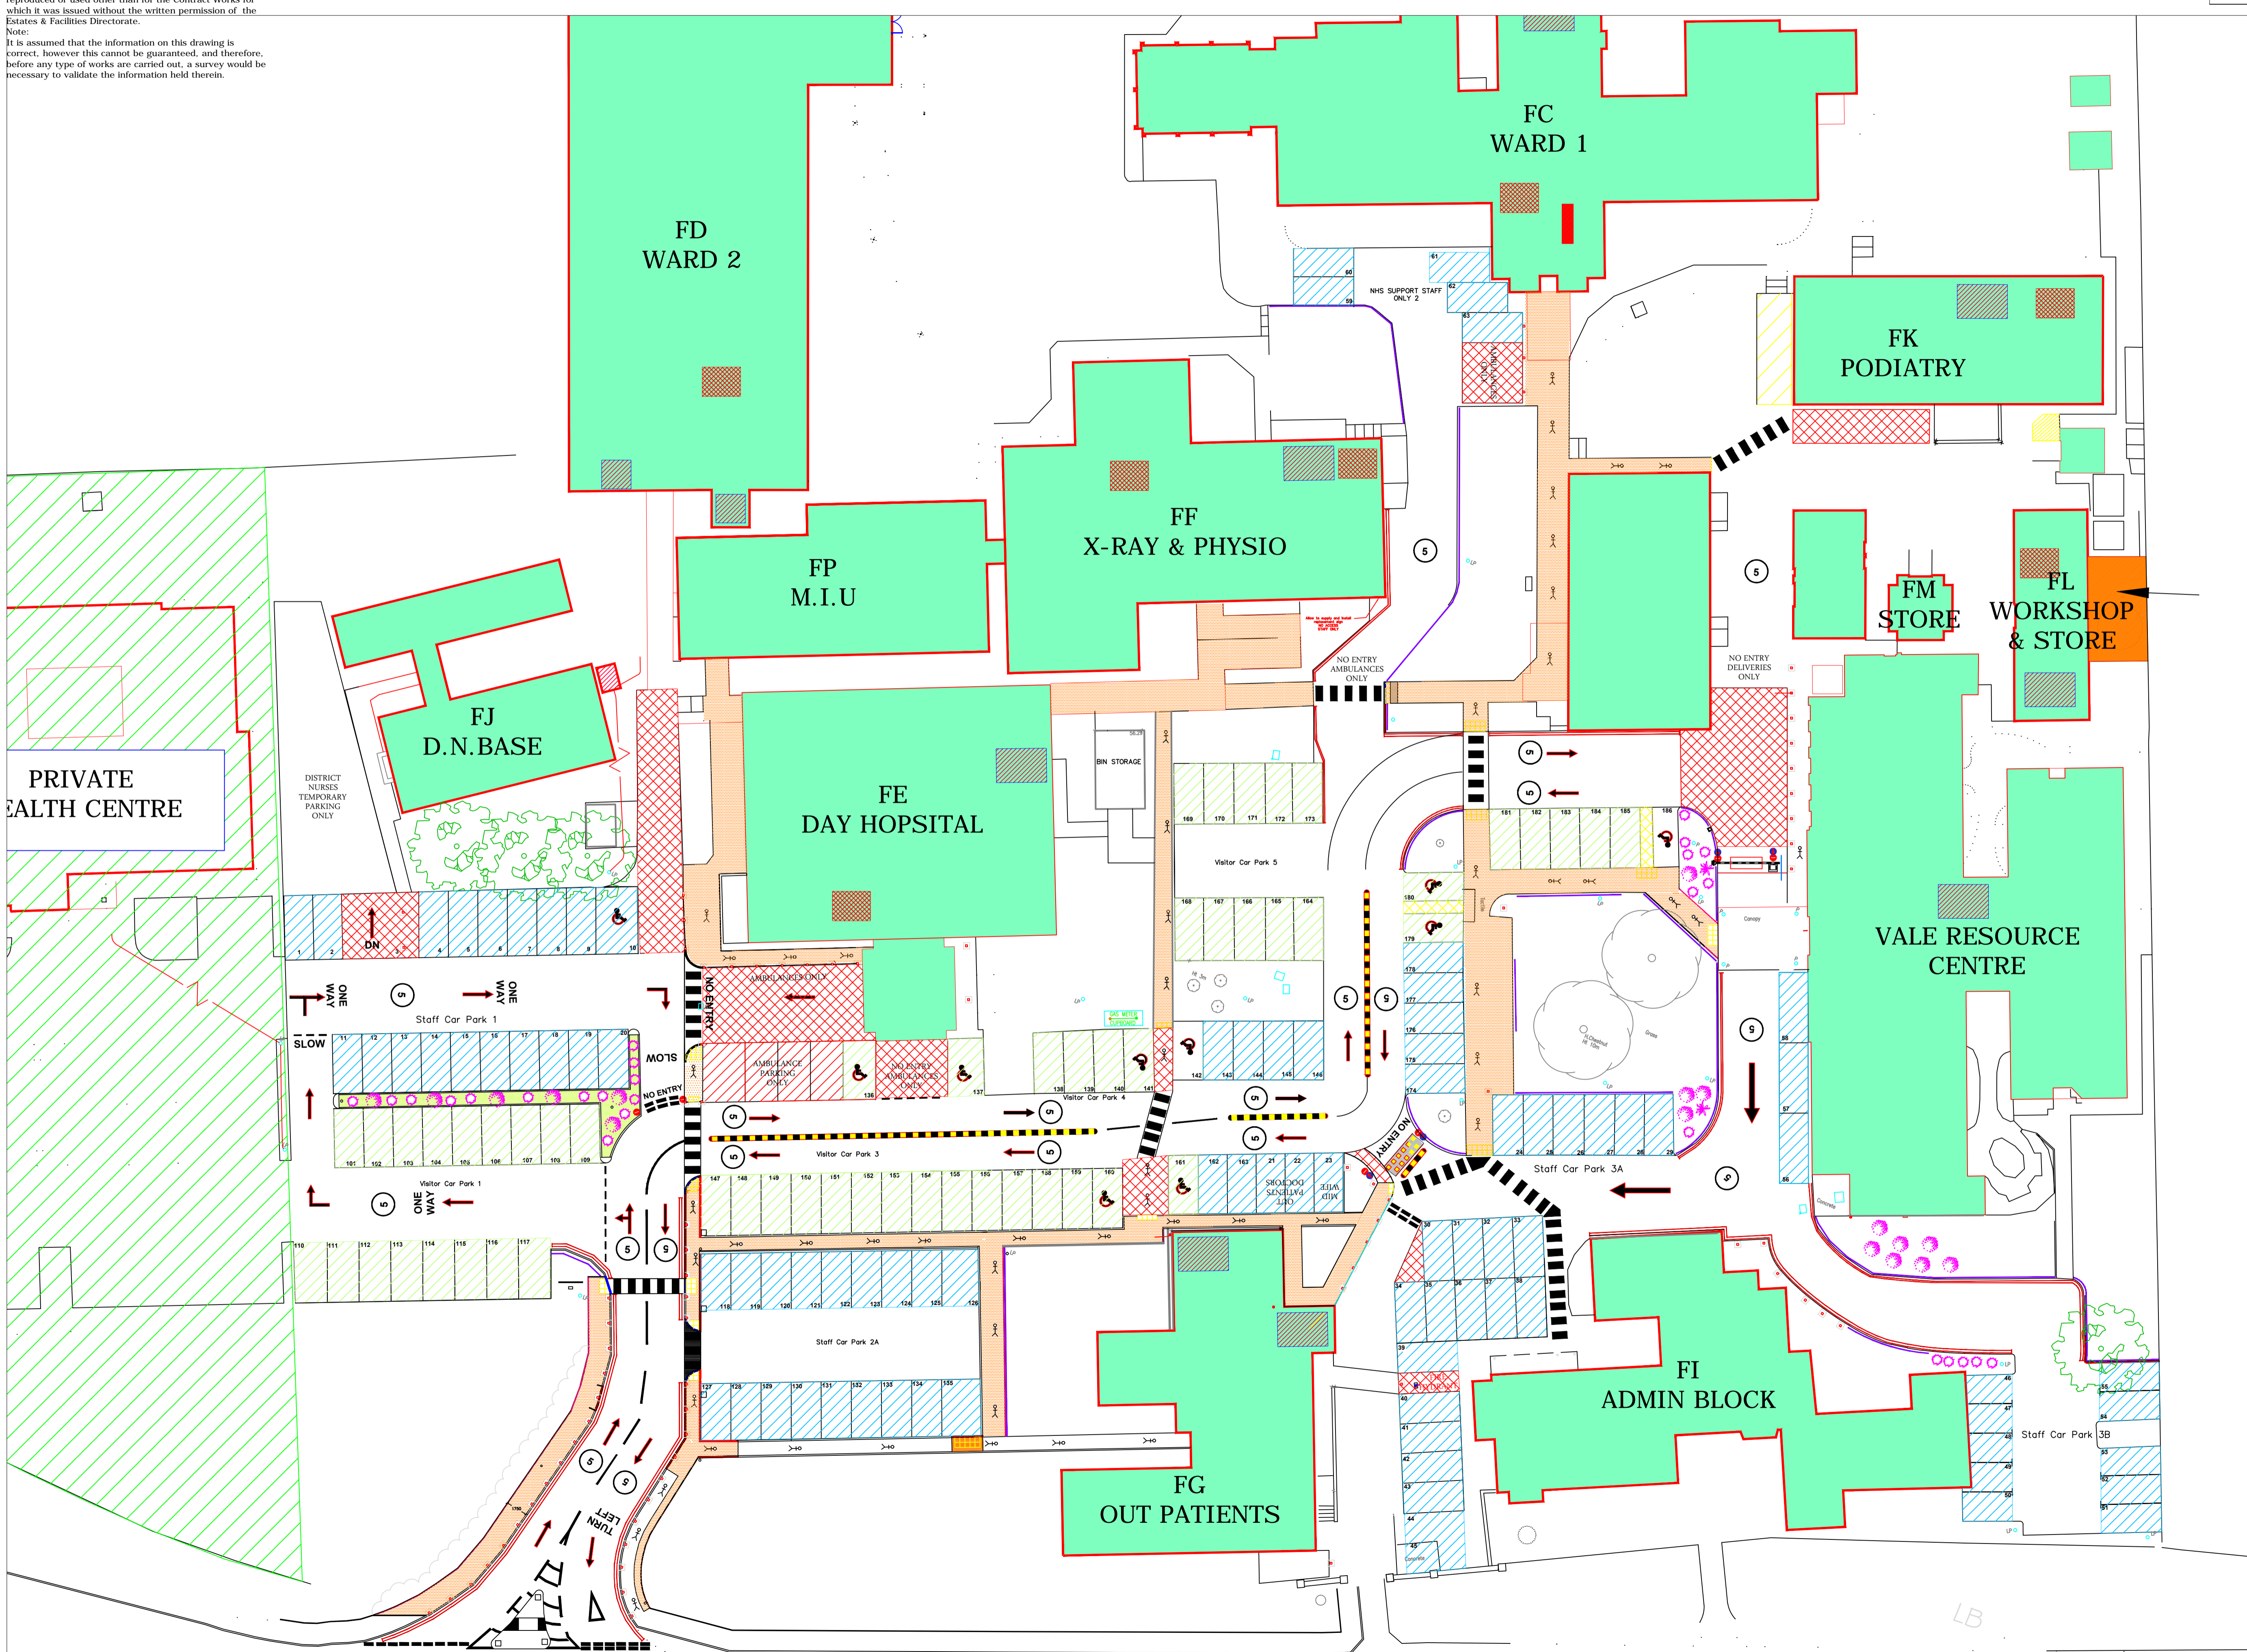

- DISABLED PARKING BLUE BADGE HOLDERS
- FOOTPATHS
- NO PARKING AMBULANCES
- NHS STAFF CAR PARKING
- VISITOR CAR PARKING

Site:  
 Abingdon Community Hospital

Drawing:  
 Car Park  
 AS BUILT LAYOUT  
 Date of last revision: OCT 2014  
 Scale: 1:250  
 Dwg. No: OH2/050/SITE/0010  
 Drawn By: Kjm

MAIN ENTRANCE

MARCHAM ROAD