


Copyright:
 This drawing is copyright and may not be altered,
 reproduced or used other than for the Contract Works for
 which it was issued without the written permission of the
 Estates & Facilities Directorate.
 Note:
 It is assumed that the information on this drawing is
 correct, however this cannot be guaranteed, and therefore,
 before any type of works are carried out, a survey would be
 necessary to validate the information held therein.

Rev A: Waste compound moved
 Rev B: Additional road markings added
 Rev C: etc...

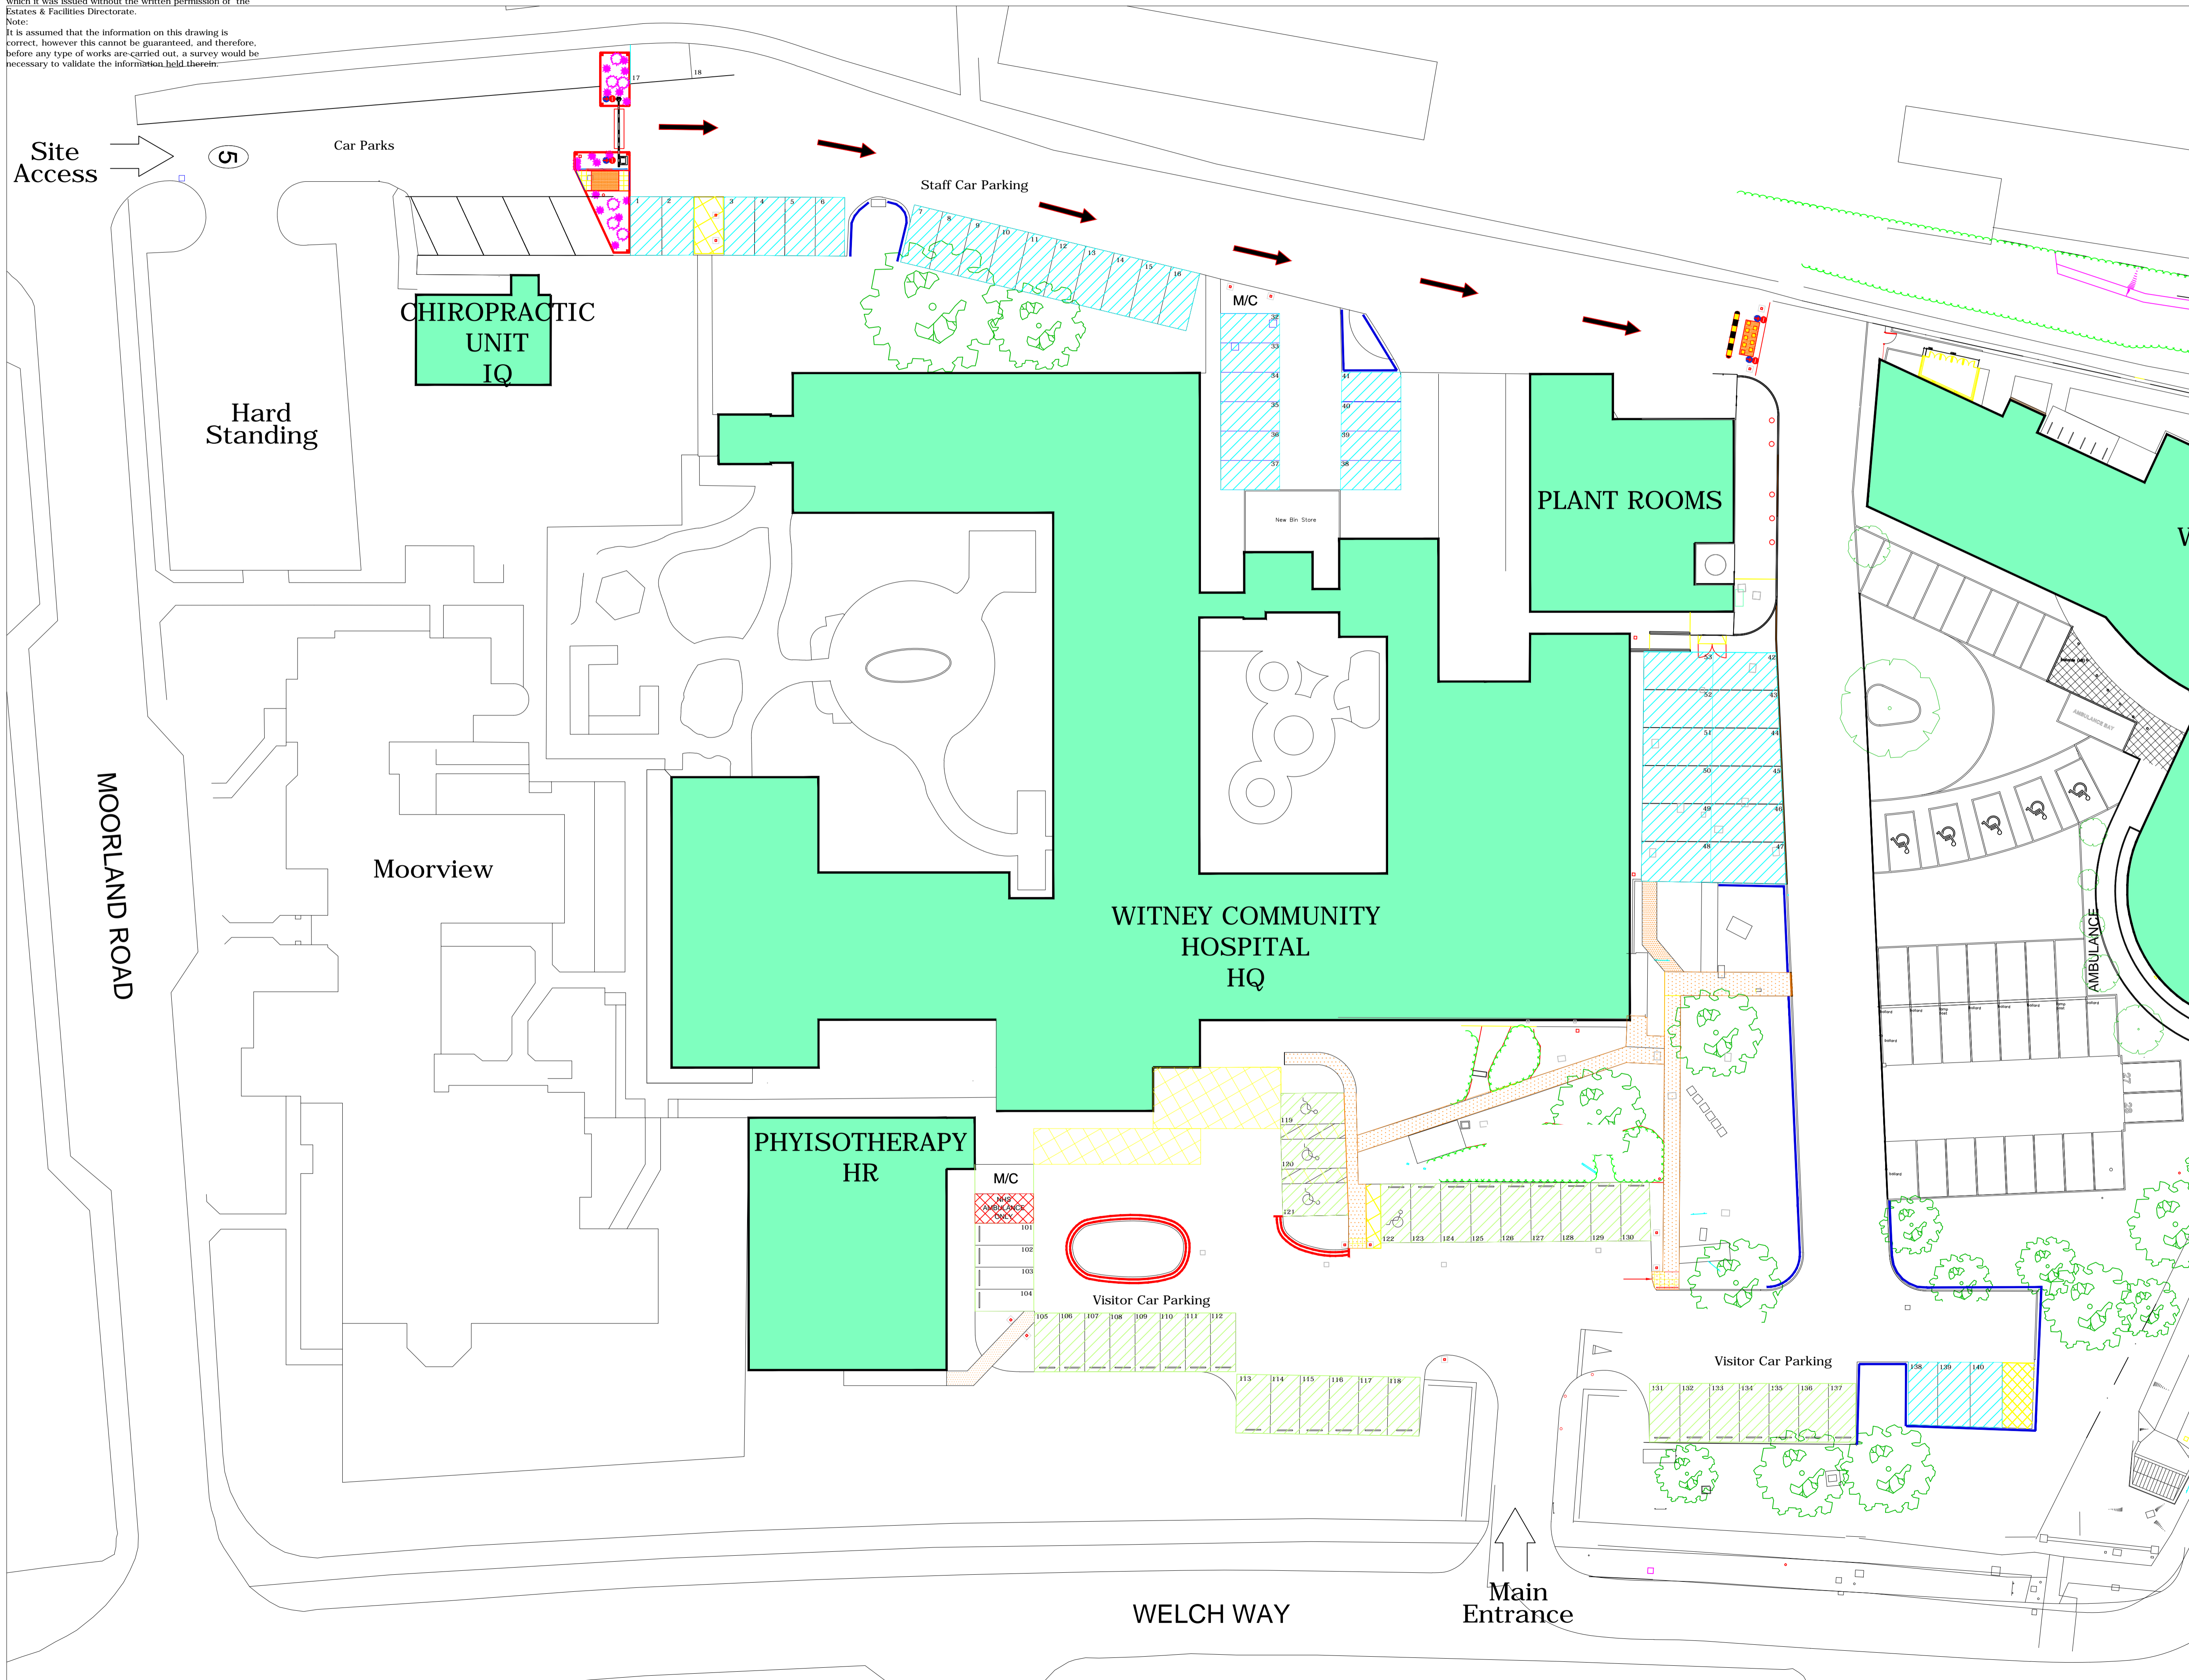

- DISABLED PARKING BLUE BADGE HOLDERS
- FOOTPATHS
- NO PARKING AMBULANCES
- NHS STAFF CAR PARKING
- VISITOR CAR PARKING

Site:
 Witney Community Hospital

Drawing:
 Car Park
 AS BUILT LAYOUT
 Date of last revision: OCT 2014
 Scale: 1:250
 Drawn By: Kjm
 Dwg. No: OHZ/094/SITE/101