


Copyright:
 This drawing is copyright and may not be altered, reproduced or used other than for the Contract Works for which it was issued without the written permission of the Estates & Facilities Directorate.
 Note:
 It is assumed that the information on this drawing is correct, however this cannot be guaranteed, and therefore, before any type of works are carried out, a survey would be necessary to validate the information.

This drawing is the product of a measured survey: NO

Rev A: Waste compound moved
 Rev B: Additional road markings added
 Rev C: etc...

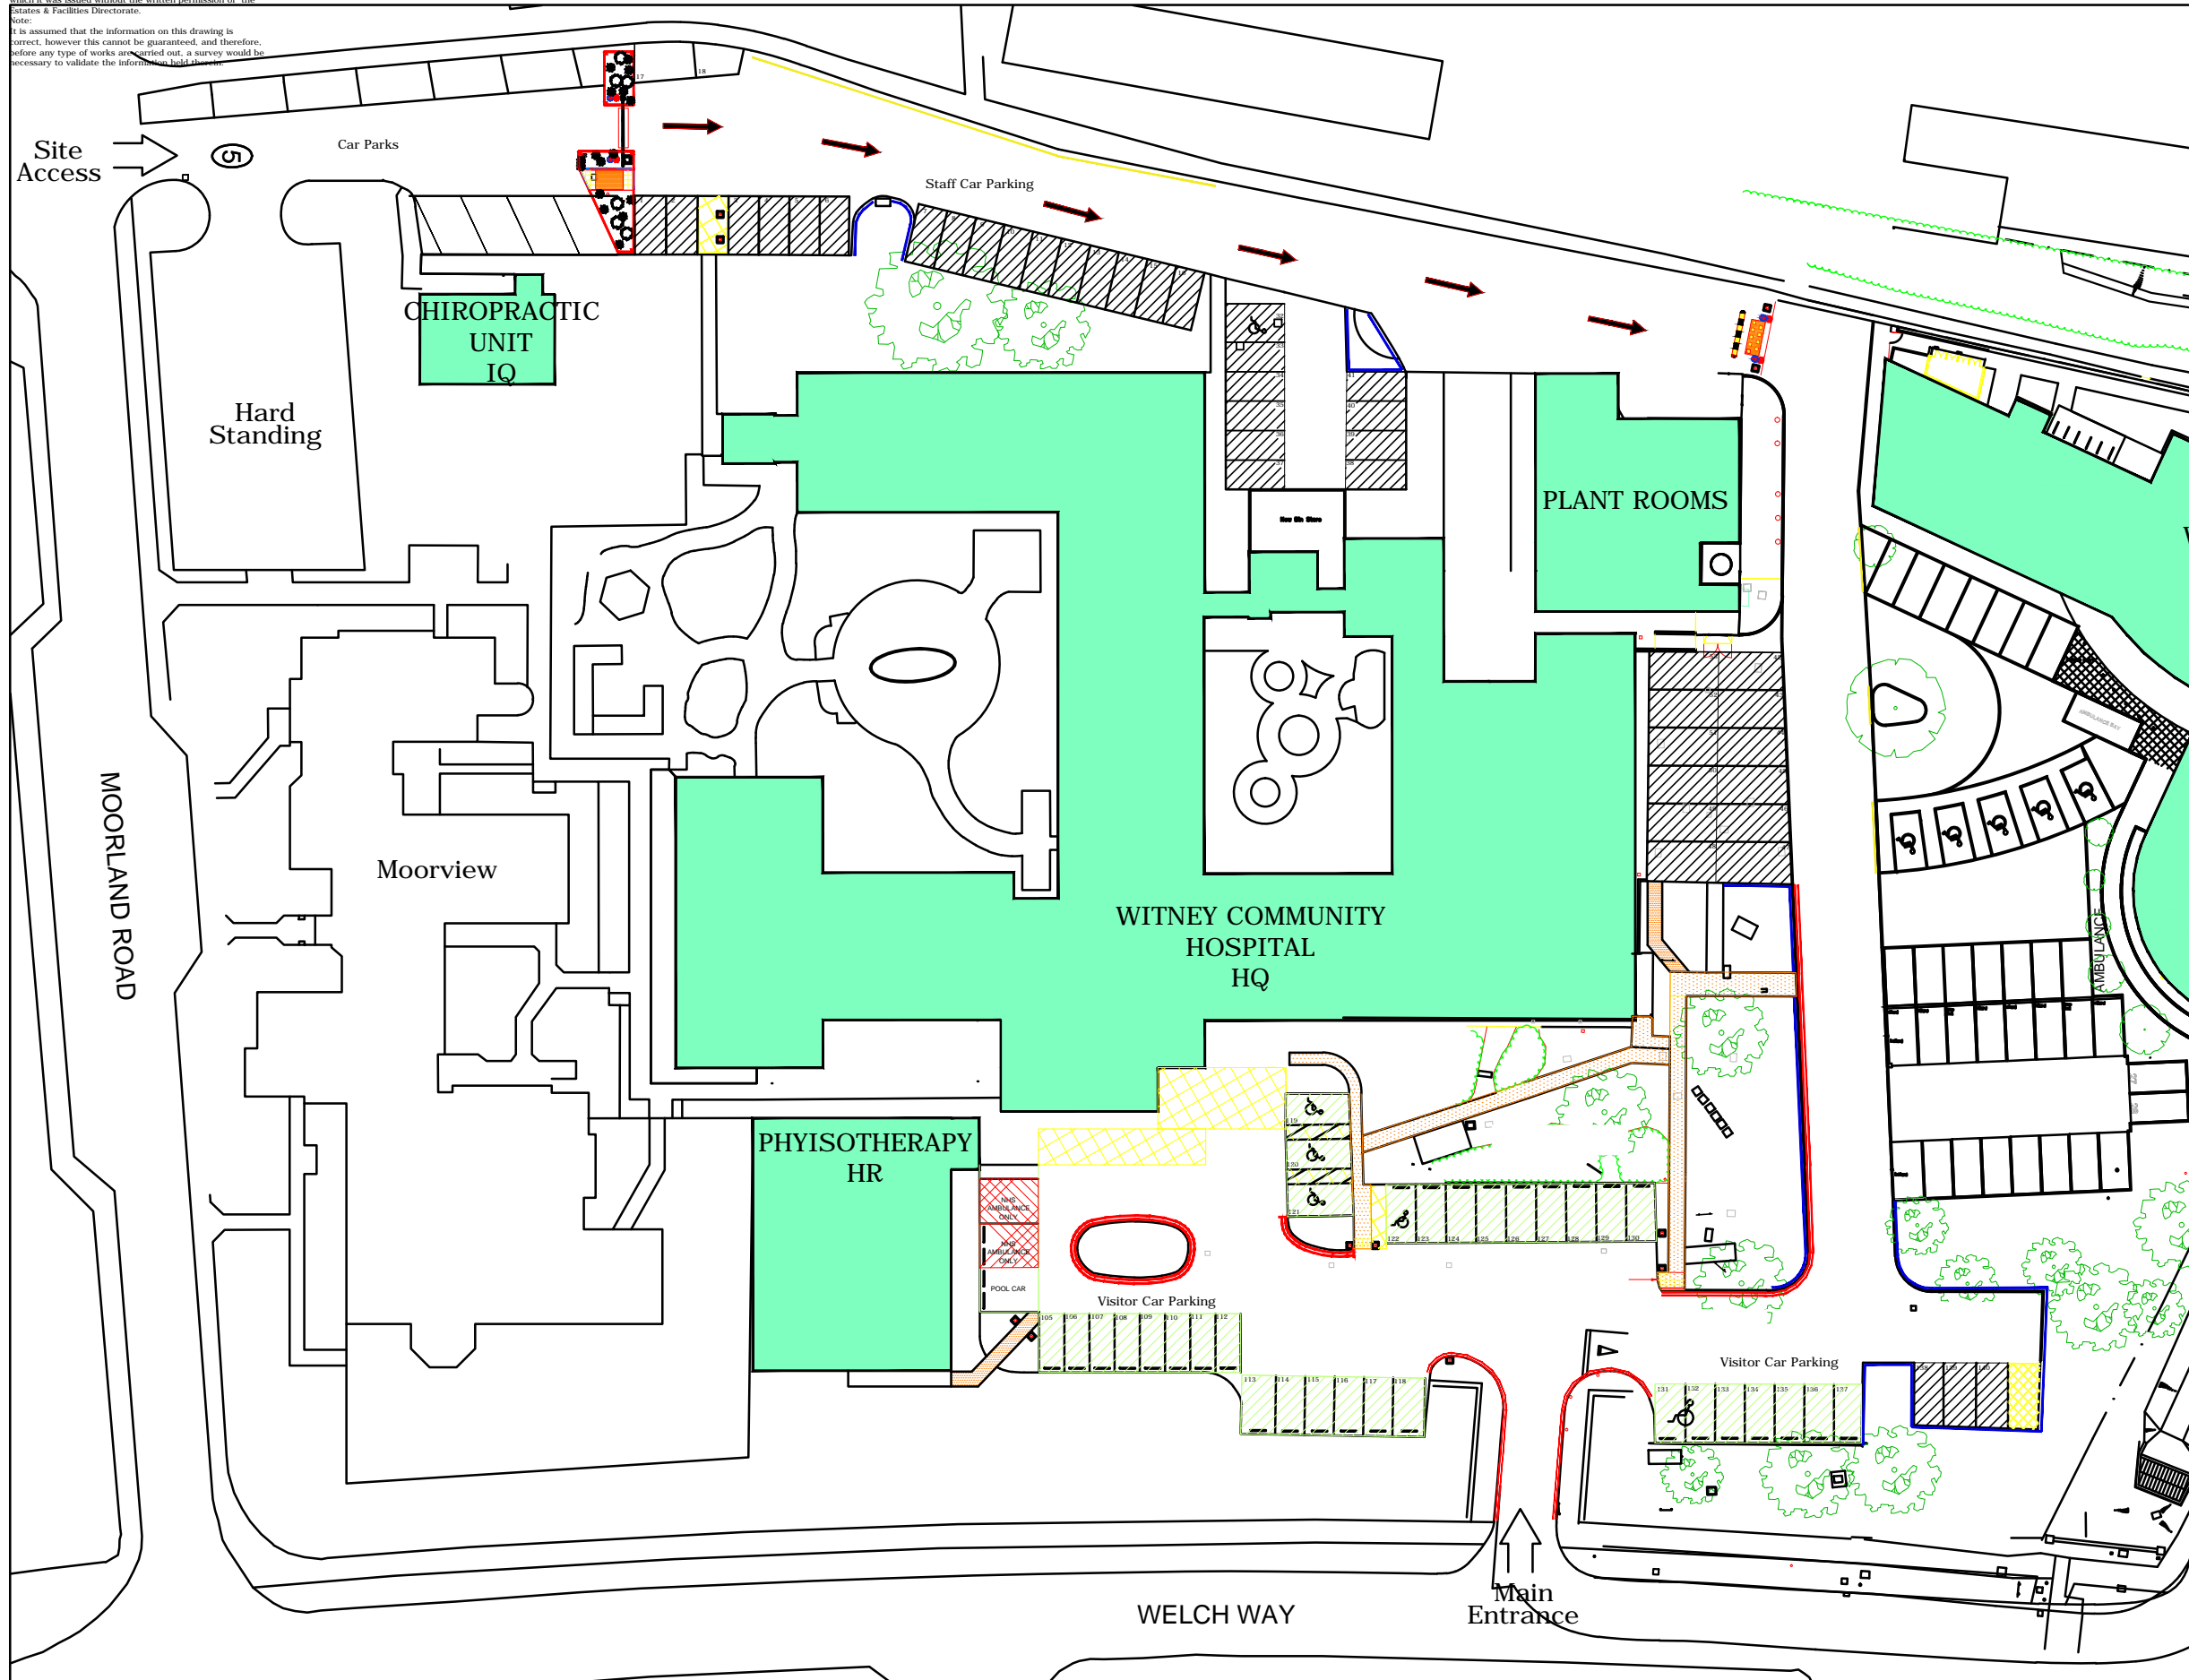

-  DISABLED PARKING BLUE BADGE HOLDERS
-  FOOTPATHS
-  NO PARKING AMBULANCES
-  NHS STAFF CAR PARKING
-  VISITOR CAR PARKING

Site:
 Witney Community Hospital

Drawing:
 Car Park
 AS BUILT LAYOUT

Date of last revision: OCT 2014
 Scale: 1:250
 Drawn By: Kjm

Dwg. No:
 OH2/094/SITE/101